



ENCOMPASS STUDIO
architecture + interiors

241 W. Charleston Blvd. Suite 155 | Las Vegas, NV 89102
design@estudiovegas.com 702.733.7759

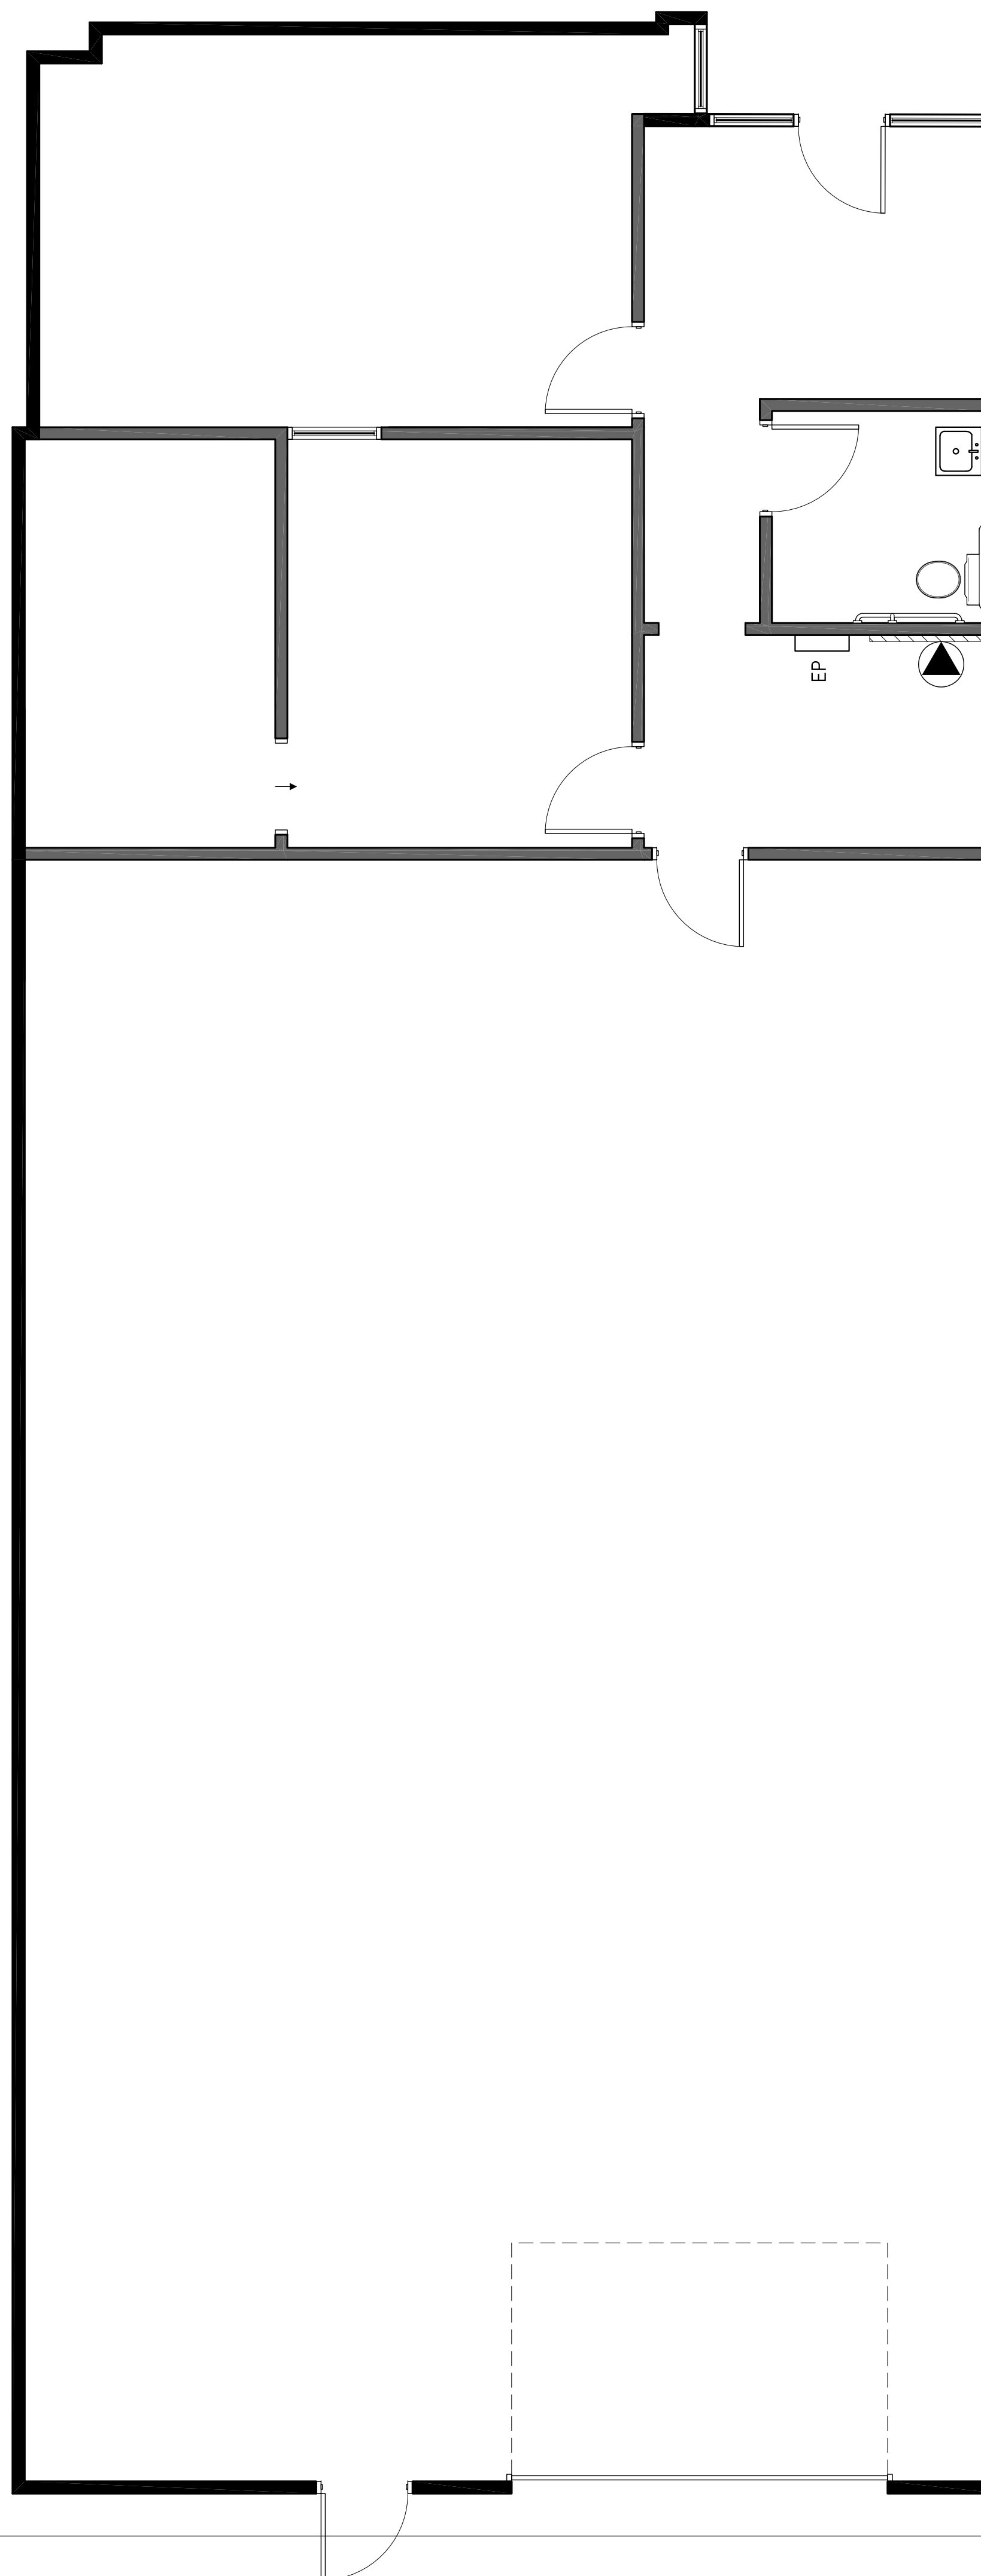

AS BUILT - 2,846 S.F.

SCALE: 1/4"=1'-0"

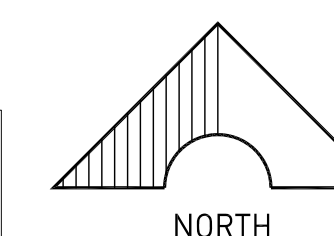

AS-BUILT
LEVEL ONE

for
SPEC SUITE - SUITE 2
6045 HARRISON DRIVE
LAS VEGAS, NV 89120

SEAL

REVISIONS:

NO.	DATE / COMMENTS	BY

DATE: 11.08.18
PROJECT NO. 10107

DRAWN BY: J.F.
CHECKED BY: D.H.

SHEET NUMBER

AI-1.0