



SUITE DATA:

OFFICE AREA	869 SF
WAREHOUSE AREA	200 SF
COMMON AREA	79 SF
TOTAL SUITE AREA	1148 SF

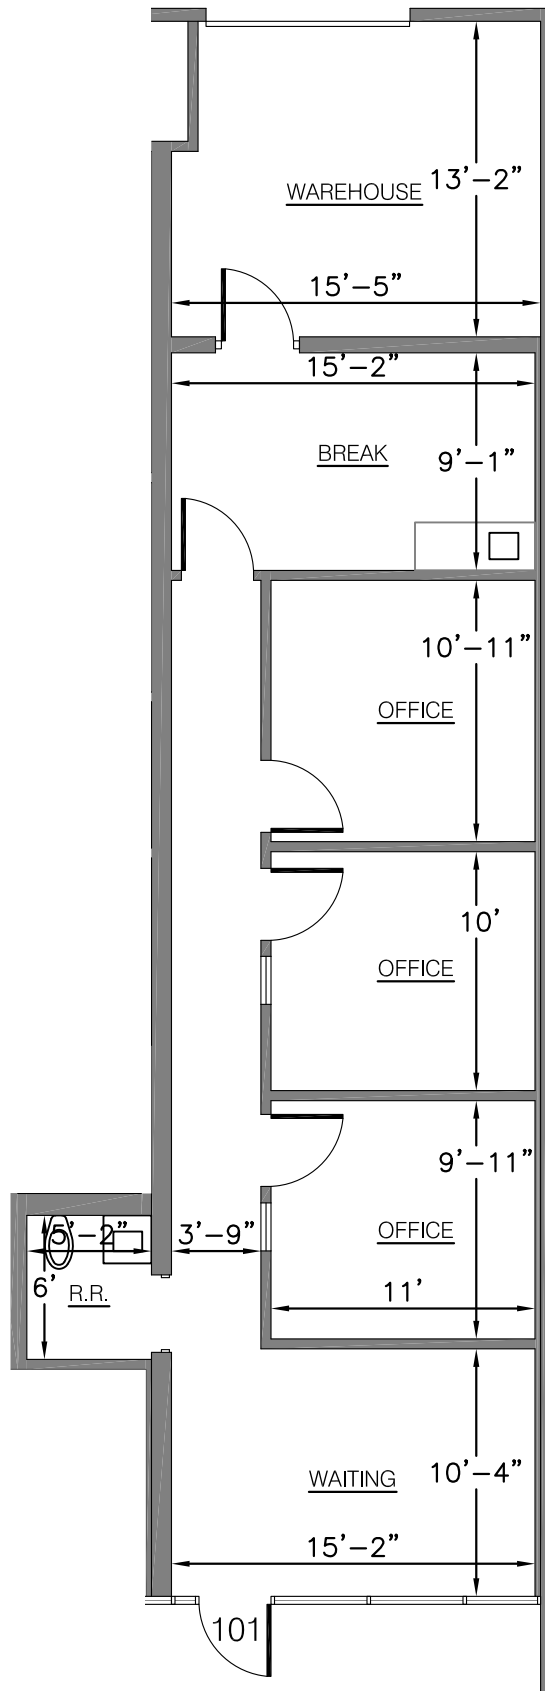

BUILDING KEY PLAN

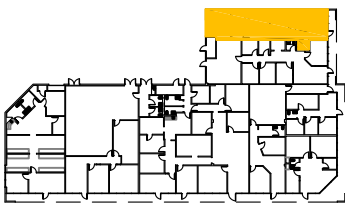

MeasuredPoint
 3D Laser Scanning • Survey • As-Builts • BIM/VDC
 60 E. Rio Salado Pkwy, Ste 900 Tempe, AZ 85281
 www.measuredpoint.com (480)369-1236 main info@measuredpoint.com

FILE LOCATION:

DATE: 4/11/19

SCALE: N.T.S.

SHEET 2 OF 9

PRINTED BY: VIGIL

DRAWING NUMBER

5024-101

TITLE:

BKM MANAGEMENT
 5024 S ASH
 BLDG 3 STE 101
 FLOOR PLAN