



North Valley Street

Parking

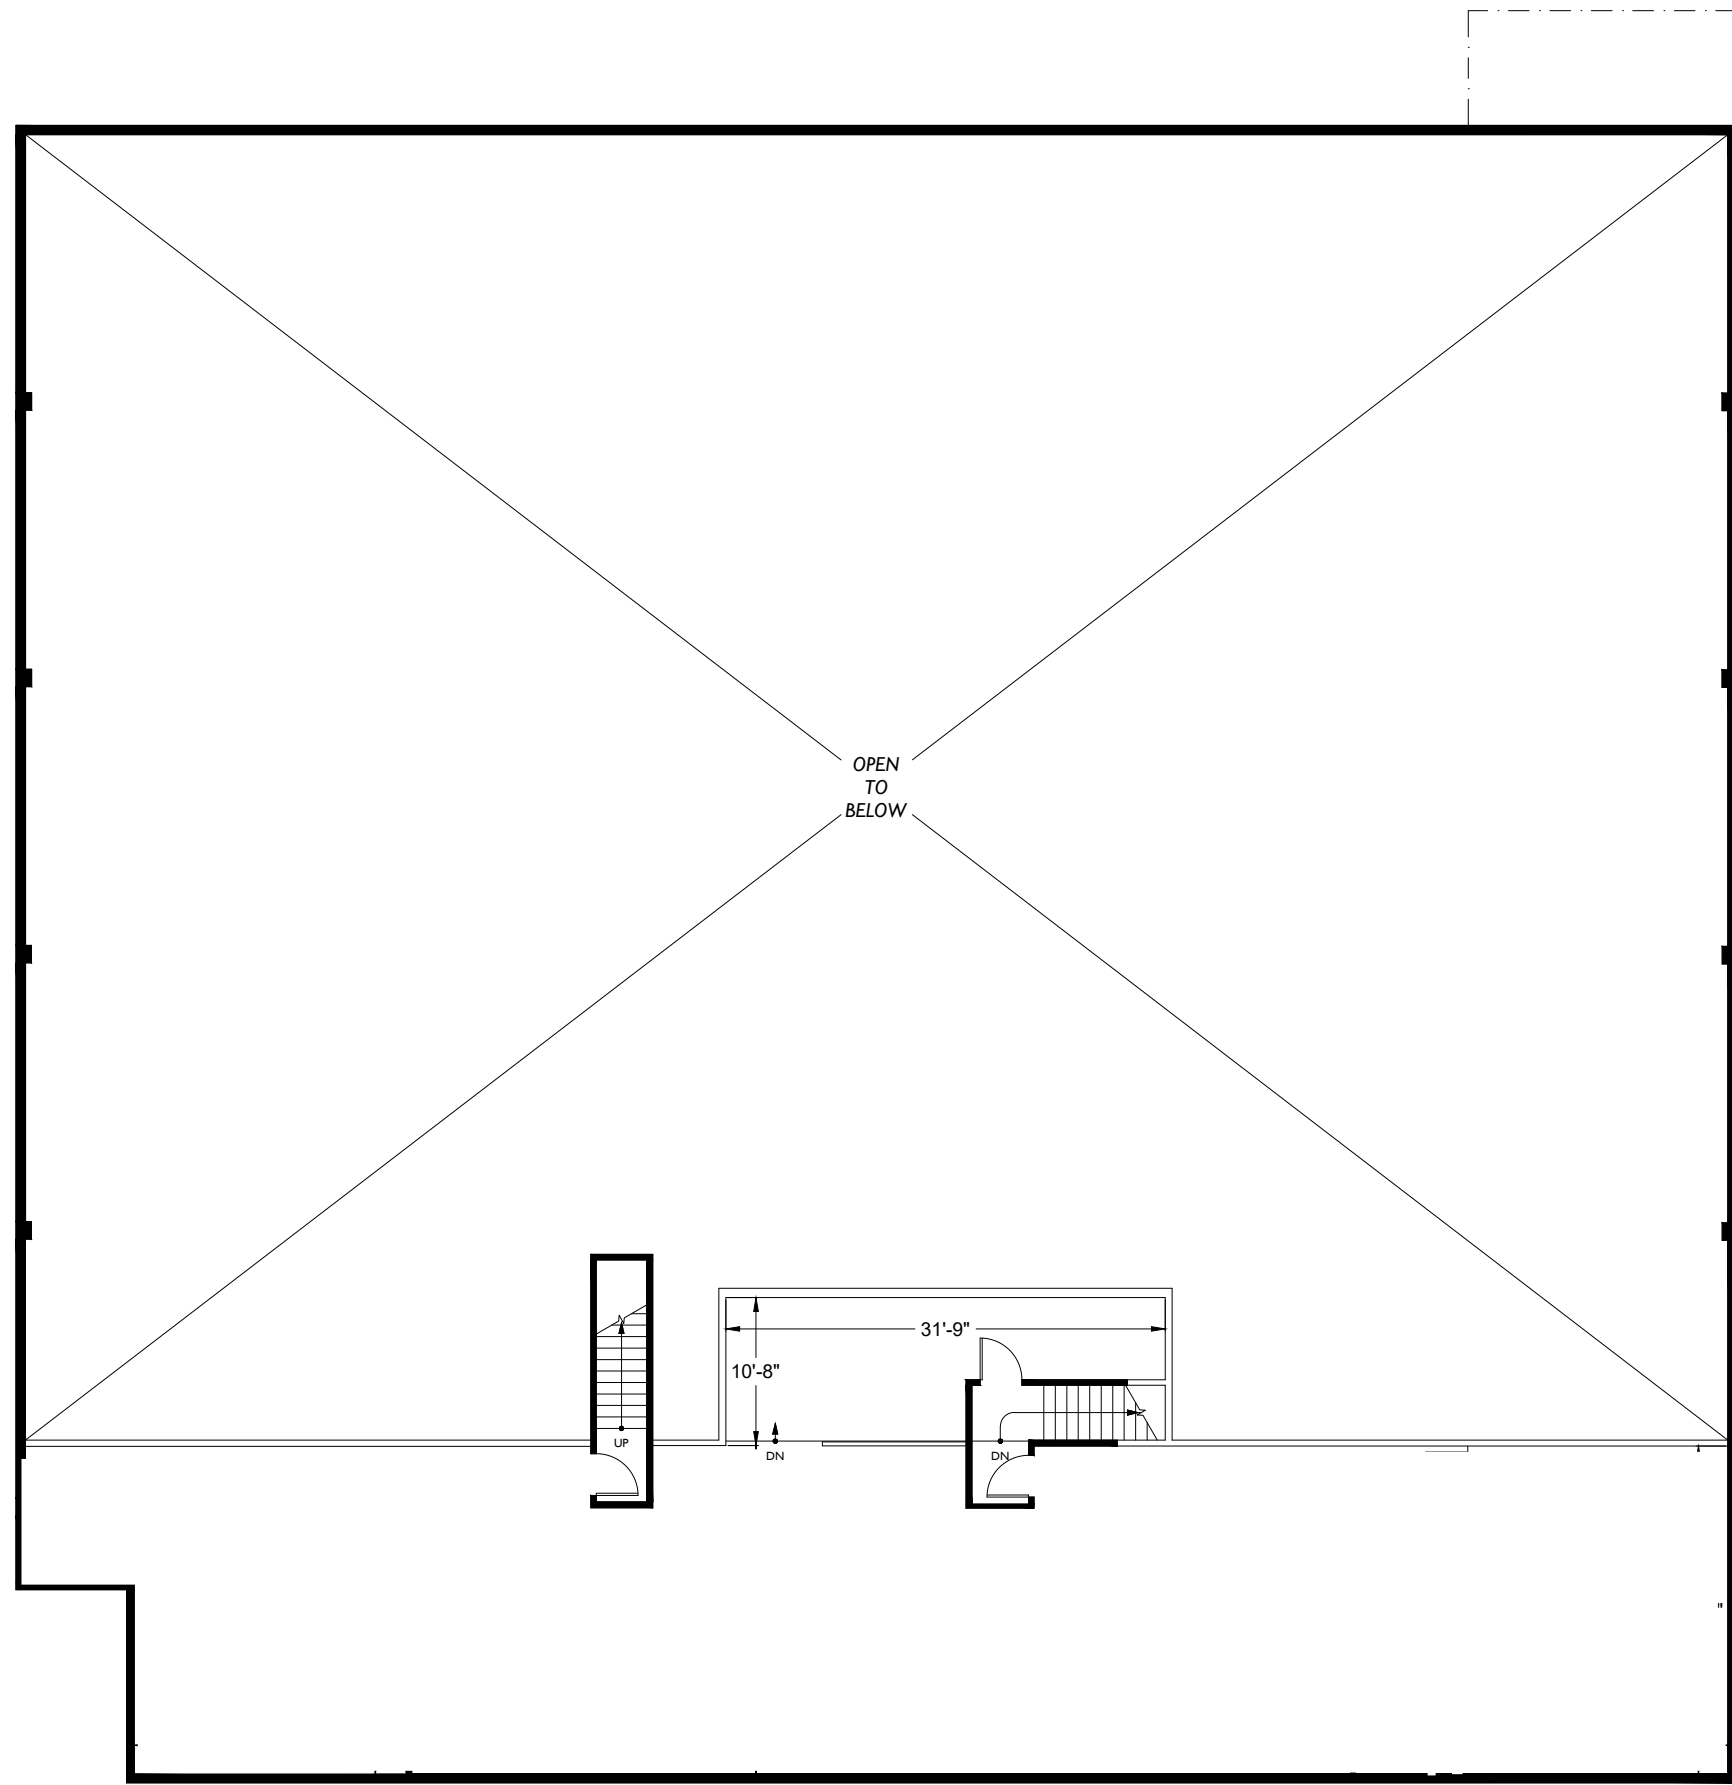

Vanowen Place

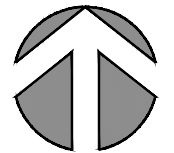

Adjacent Building

Floor Plan

MEZZ


Floor

Industrial Building
4110 Vanowen Place
Burbank, CA 91505

Subject

BKM Management Company
13177 Ramona Boulevard, Suite A
Irwindale, CA 91706

Client

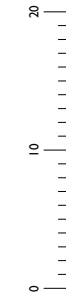

Scale

2-D
AS-BUILT
FLOOR PLANS

2DFLOORPLANS.COM
425-677-7511
600 NW Gilman Blvd. Suite E
Issaquah, WA 98027

Measured: January 2020

Project: C20-137