


West Valley Highway
 Parking Lot
 Neighboring Buildings
 Loading Area


South 192nd Place
 Parking Lot
 Neighboring Building

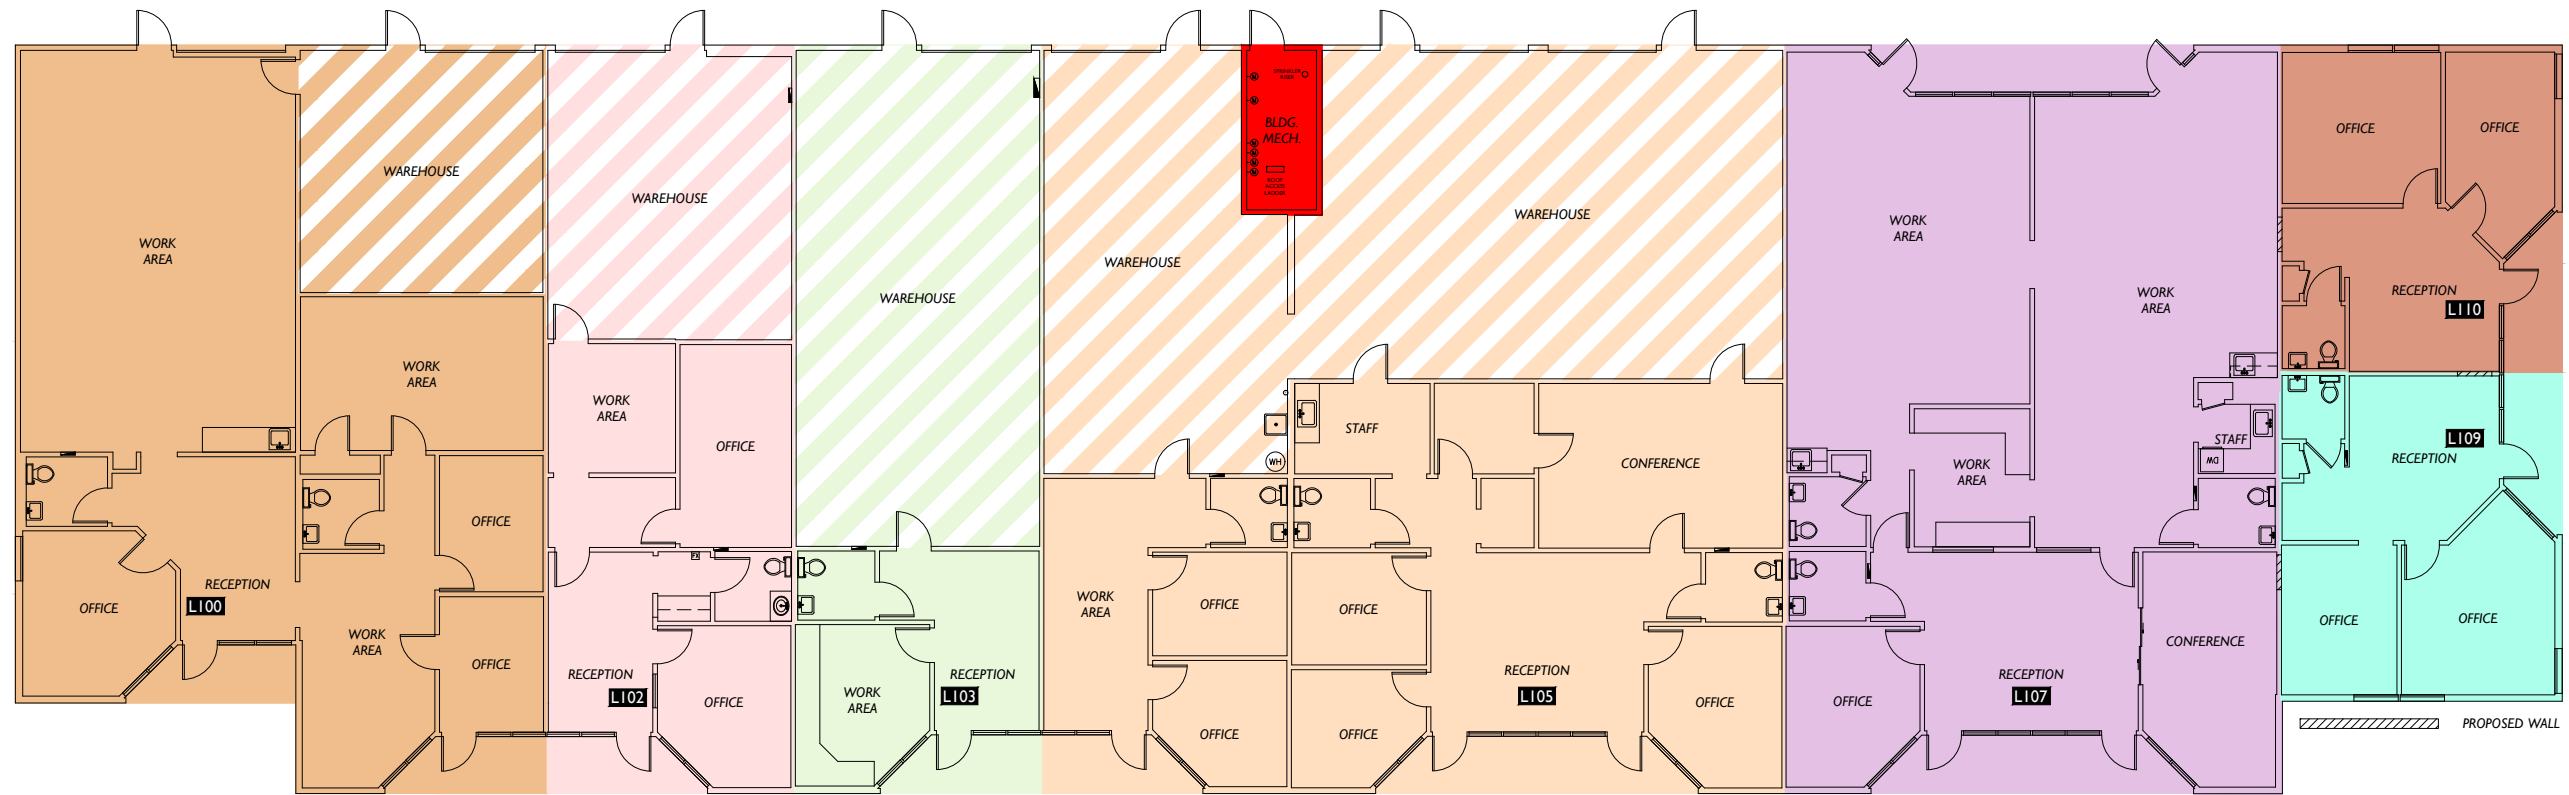

Parking Lot
 South 193rd Place

Lease Plan

Floor

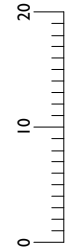


Scale

Floor Summary	SQ. FT.
Total Rentable Area	13,977.62
Total Occupant Area	13,874.43
Building Service Area	103.19
Total Vertical	0

Suite #	Occupant Area	Rentable Area
Suite L100	2,333.78	2,351.14
L100 Warehouse	465.64	469.10
Suite L102	843.97	850.25
L102 Warehouse	555.61	559.74
Suite L103	457.14	460.54
L103 Warehouse	940.76	947.76
Suite L105	2,131.55	2,147.40
L105 Warehouse	1,956.94	1,971.49
Suite L107	2,790.85	2,811.61
Suite L109	699.97	705.18
Suite L110	698.22	703.41

Area Analysis performed in accordance with ANSI/BOMA Z65.2 - 2012 Method B Standard.

Parking Lot
 66th Avenue South

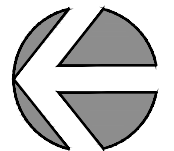

West Valley Business Park - Bldg L
 19226 66th Avenue South
 Kent, WA 98052


BKM Management Company
 1701 Quail Street Suite 100
 Newport Beach, CA 92660

Client

Subject

Lease Plan

Floor

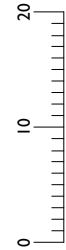

Scale

2DFLOORPLANS.COM
 425-677-7511
 600 NW Gilman Blvd. Suite E
 Issaquah, WA 98027

2-D
 AS-BUILT
 FLOOR PLANS

Updated: December 2019 Project: C19-848